


AS BUILT FLOOR PLANS

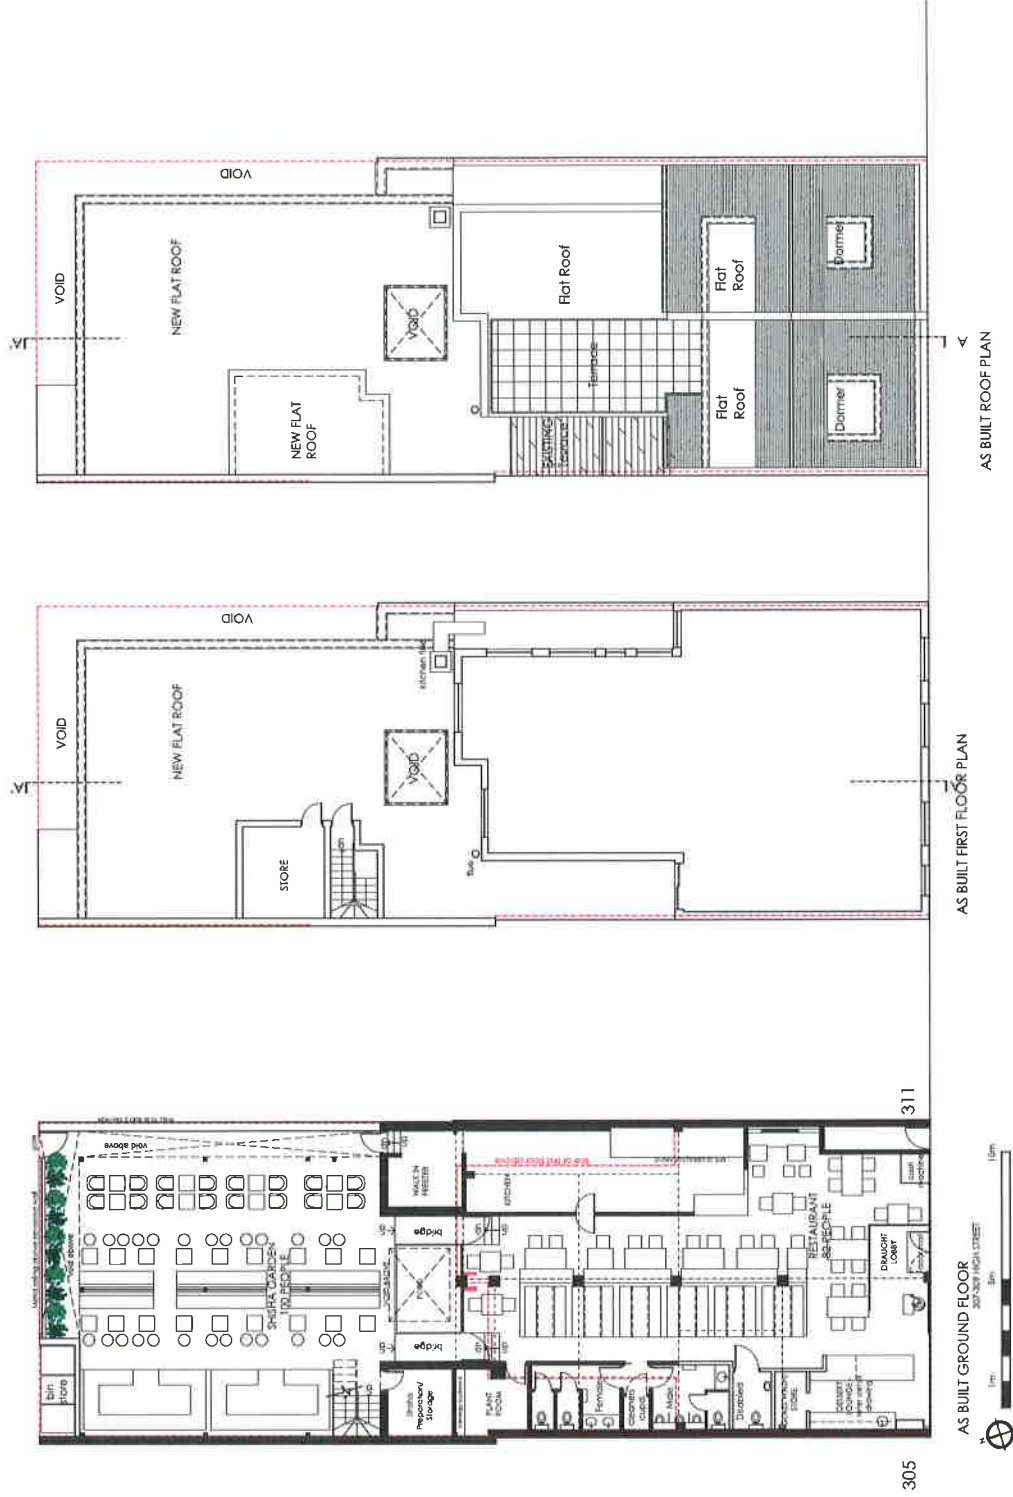

| | | | | | | | | | |
|-------------------|-------------------------------------|---------------|---------------------|--------|--|------|------------|-------------|-------|
| PROJECT | 307-309 HIGH STREET, SLOUGH SL1 1BD | DWG NO./SCALE | 06 1:100 @ A1 | DETAIL | AS BUILT FLOOR PLANS | DATE | 14.01.2020 | PROJECT NO. | 18.01 |
| AS BUILT BUILDING | | | | | SENT TO PLANNING DEPT. SLOUGH | | | | |